

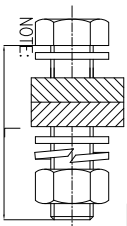
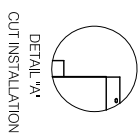
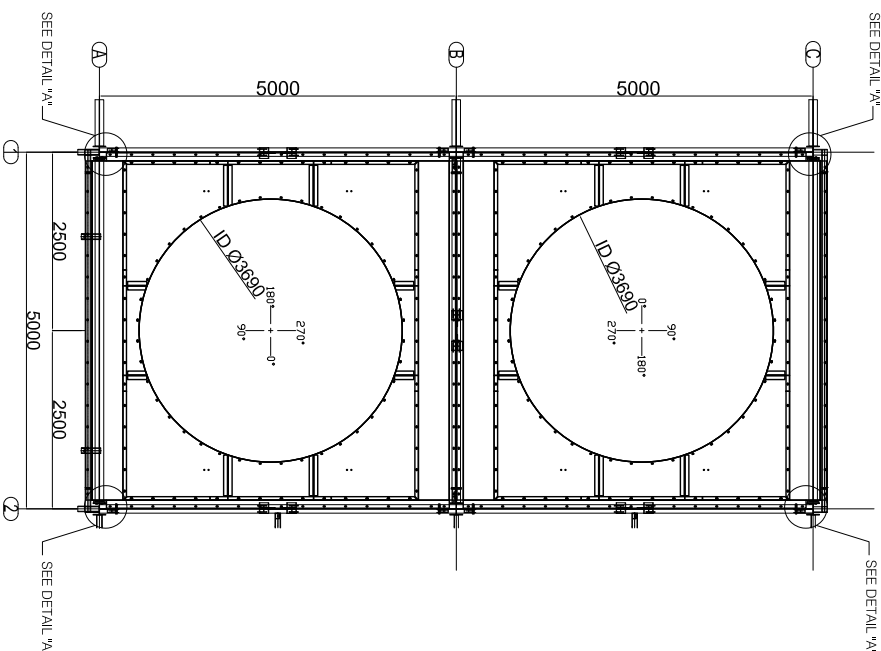


PLENUM & DECK PLATE - DEVELOPMENT VIEW

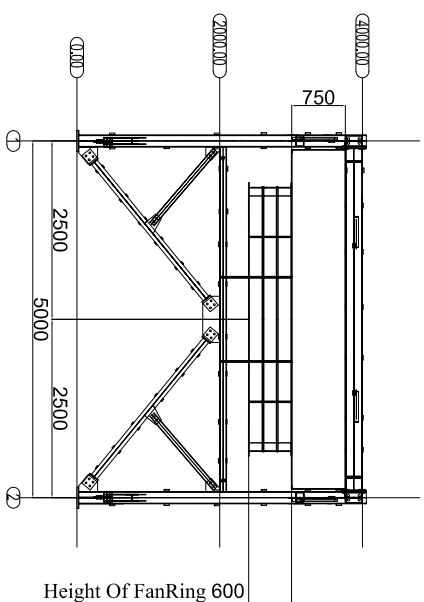

FOR ALL ITEMS:
ALL BOLTS SHOULD BE FASTENED WITH
ONE NUT AND TWO FLAT WASHER AND ONE SPRING WASHER

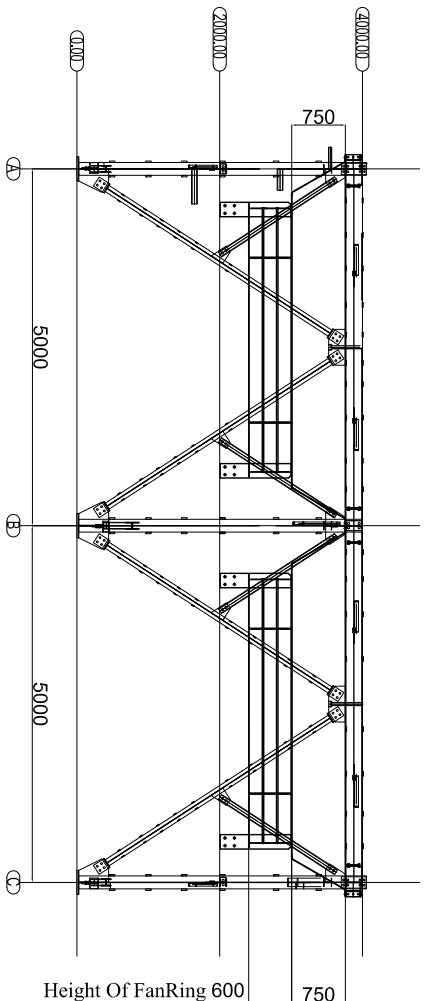

CUT INSTALLATION


DRAWINGS	
TITLE	DWG. No.
General Arrangement Drawing for Air Cooler	SPHT-1G0004-ME-VDMG-AE1501-004
Steel Structure Drawing	SPHT-1G0004-ME-VDMG-AE1501-010
Fan & Motor Support Drawing	SPHT-1G0004-ME-VDMG-AE1501-013
Fan & Pulley Guard Drawing	SPHT-1G0004-ME-VDMG-AE1501-019

NOTES

- 1--ALL DIMENSIONS ARE IN mm EXCEPT SPECIFIED.
- 2--MARKING : 17180-AE1501--PL--PART NO.
- 3--SURFACE PROTECTION:HOT DIP GALVANIZED A123 & A153
- PAINTING ACCORDING TO SDHT-TG0004-ME-VPRC-0405-010
- BOLT ARE M12x40
- BOLTING : DIN EN ISO 4017/ DIN EN ISO 4032
- 4--TWO FLAT WASHER : DIN 125
- 5--TOTAL REQUIRED QUANTITY FOR M12x40= 164(SETS/UNIT)
- 6--QUANTITY : 2*1=2
- 7--ALL BOLTS WHICH FASTEN PLENUM TO THE STRUCTURE SHALL BE 20*50 .
- 8--TOTAL REQUIRED QUANTITY FOR M12x50= 66(SETS/UNIT)

Code1	<input type="checkbox"/>	Approved (Vendor shall issue "AFC"/ "FIN" status)
Code2	<input type="checkbox"/>	Approved as noted (Vendor to amend and submit the "Issued for Approval" status)
Code3	<input type="checkbox"/>	Commented (Vendor to amend and submit the "Issued for Approval" status)
Code4	<input type="checkbox"/>	Rejected (Vendor to resubmit with same revision)

The above checking result by Purchaser shall in no way relieve Vendor of any liability, obligation and responsibility out of the purchase order and the mutual agreement in writing

 <p>Oil Design & Construction Co.</p>	DATE :
	DEPT:
Signature :	

Only for internal review					
CV	PI	EL	IN	ME	MA
ST	MC	PR	SF	HV	TC

REV	DATE	DESCRIPTION	PREP.	CHK.	APP.
03	14-Mar-2021	AS BUILT NOT SEND	ZJant	Mtroost	P.kermibooch
02	09-Mar-2021	AS BUILT NOT SEND	ZJant	Mtroost	P.kermibooch
01	08-Mar-2021	ISSUED FOR APPROVAL	ZJant	Mtroost	P.kermibooch
00	16-Feb-2021	ISSUED FOR APPROVAL	ZJant	Mtroost	P.kermibooch

DISTILLATE HYDROTREATING
PROJECT SHIRAZ OIL REFINERY

7E:

Plenum & Fan Ring Drawing AE-1501




















PREP.: Z.Zare'i	CHECK: M.Firozi	APPR.: P.Korimizadeh
CONT. JOB No.:	CONT. DWG. No.:	

DOCUMENT No.

DOCUMENT No.:	SC.:None				
	SIZE: A3				
	PROJ.	P.O NO.	DISC.	DOC TYPE	TAB NO.
	SDHTTG0004	ME	VDWG	AE1501	016
					03
					1 OF 4

FILE REF. ADDRESS:	
P.O.I.: IFA	

PART LIST FOR ONE UNIT			14	15		
NO	Dimension	Material	QTY	Uweight	Tweight	Marking
1R	150*15*3	A36	1&1 mirror	40.7	72.8	17180-AE1501-PL-1R
1L	1300*15*3	A36	1&1 mirror	40.7	72.8	17180-AE1501-PL-1L
1M	1400*15*3	A36	2	30.0	60.0	17180-AE1501-PL-1M
2R	1625*1006*3	A36	2	38.2	76.4	17180-AE1501-PL-2L
2L	1625*1006*3	A36	2	38.2	76.4	17180-AE1501-PL-2L
2M	1800*1006*3	A36	2	42.3	84.6	17180-AE1501-PL-2M
3R	1750*1470*4	A36	1&1 mirror	80.2	160.4	17180-AE1501-PL-3R
3L	1750*1470*4	A36	1&1 mirror	80.2	160.4	17180-AE1501-PL-3L
3M1	1200*633*4	A36	2	23.7	47.4	17180-AE1501-PL-3M1
3M2	1256*335*4	A36	2	13.1	26.2	17180-AE1501-PL-3M2
4	160*6*570	A36	8	3.0	24.0	
5	160*6*270	A36	5	1.5	12.0	
6	110*50*4	A36	8	0.2	1.0	
7	110*50*4	A36	5	0.2	1.0	
8	box20*2*560	A36	4	0.7	2.8	17180-AE1501-BOX-1
9	M12*40	A325		164		
10	M12*50	A325		66		
11	TAPER WASHER FOR M12	A325	32	T.Weight (kg)	878.2	

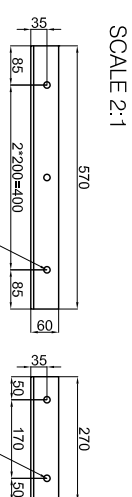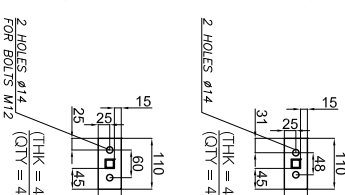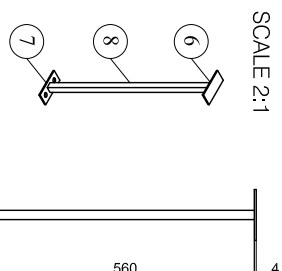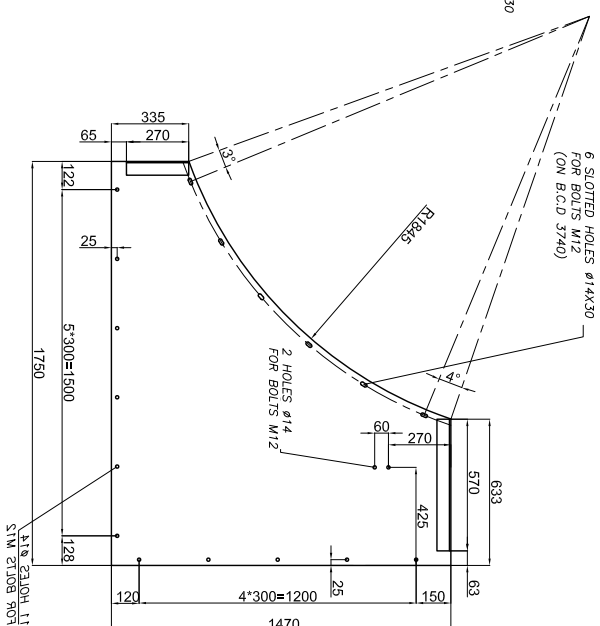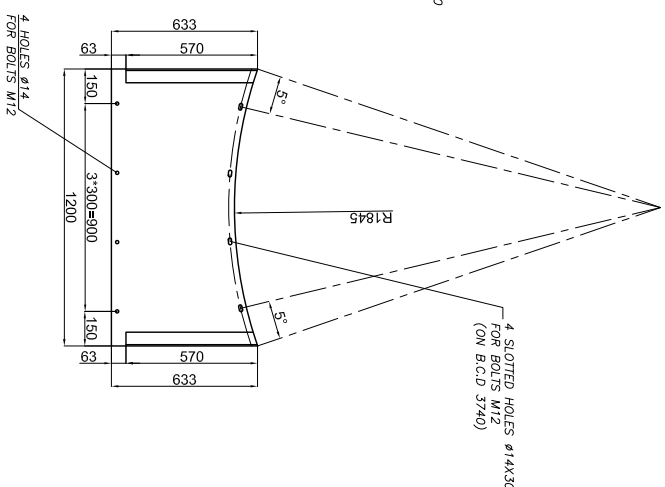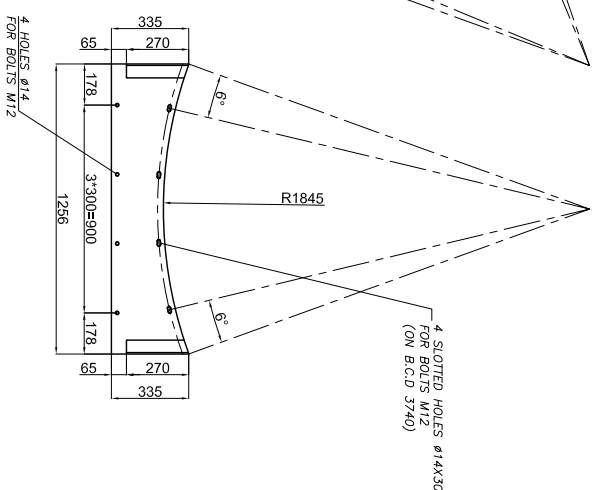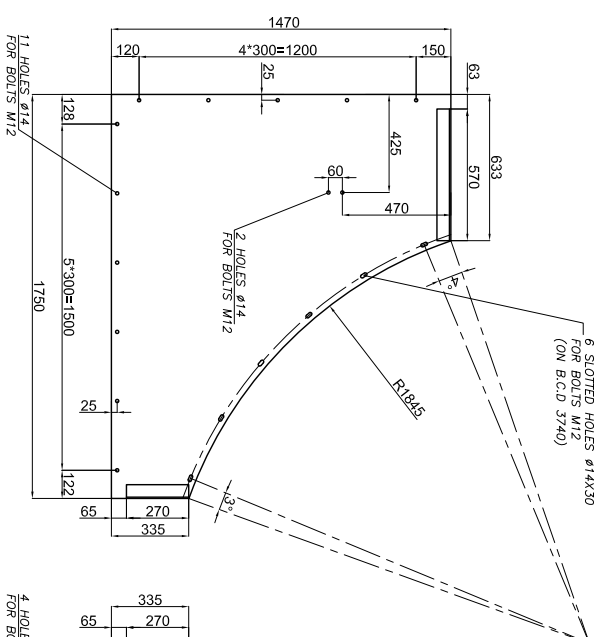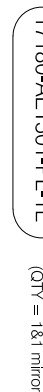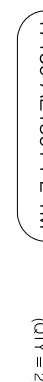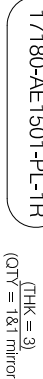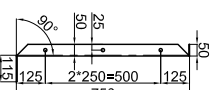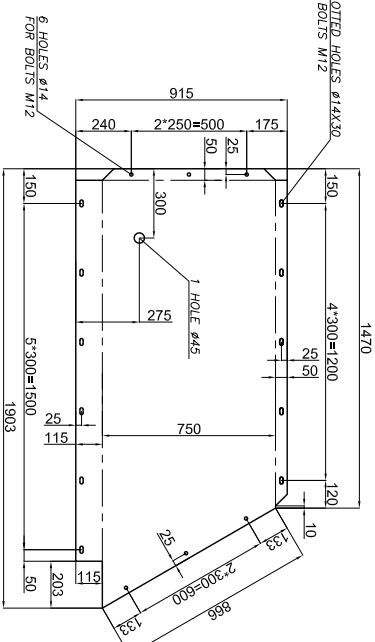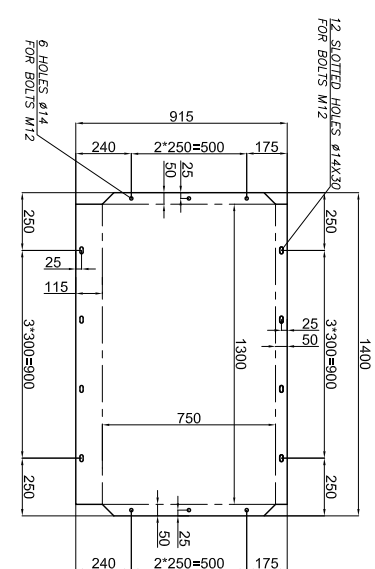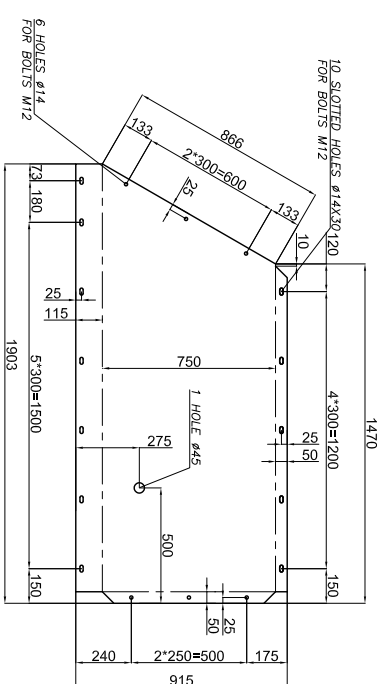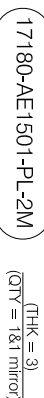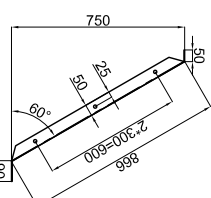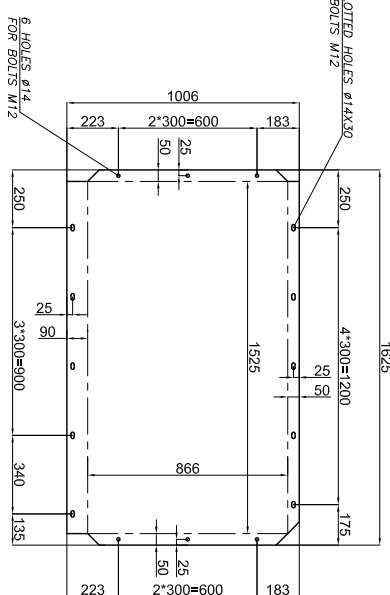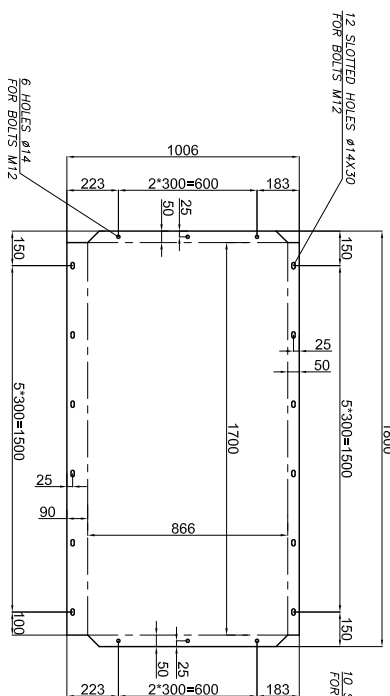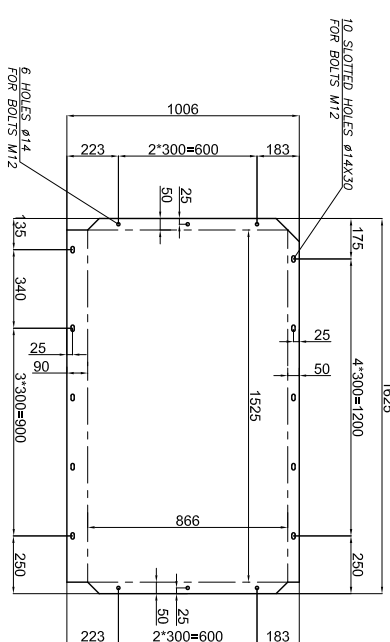

REV	DATE	DESCRIPTION	PREP.	CHK.	APP.
03	14-Mar-2021	AS BUILT NOT SEND	ZJant	Mtroost	P.krimmrich
02	09-Mar-2021	AS BUILT NOT SEND	ZJant	Mtroost	P.krimmrich
01	08-Mar-2021	ISSUED FOR APPROVAL	ZJant	Mtroost	P.krimmrich
00	16-Feb-2021	ISSUED FOR APPROVAL	ZJant	Mtroost	P.krimmrich

DISTILLATE HYDROTREATING
PROJECT SHIRAZ OIL REFINERY

AAC




Plenum & Fan Ring Drawing AE-1501

PREP.: Z.Zare'i	CHECK: M.Firoozi	APPR.: P.Karimzadeh
-----------------	------------------	---------------------

DOCUMENT No.:	Sc:None
	SIZE: A3



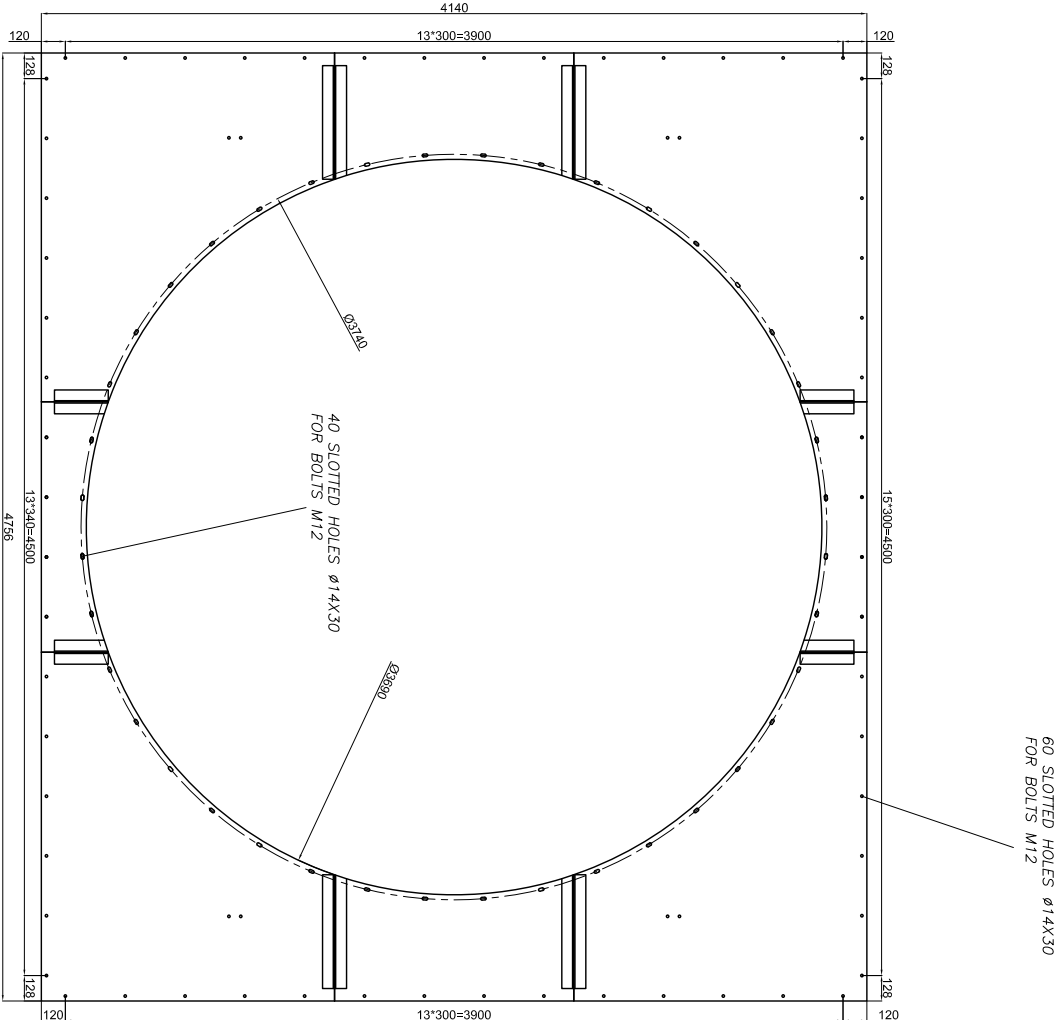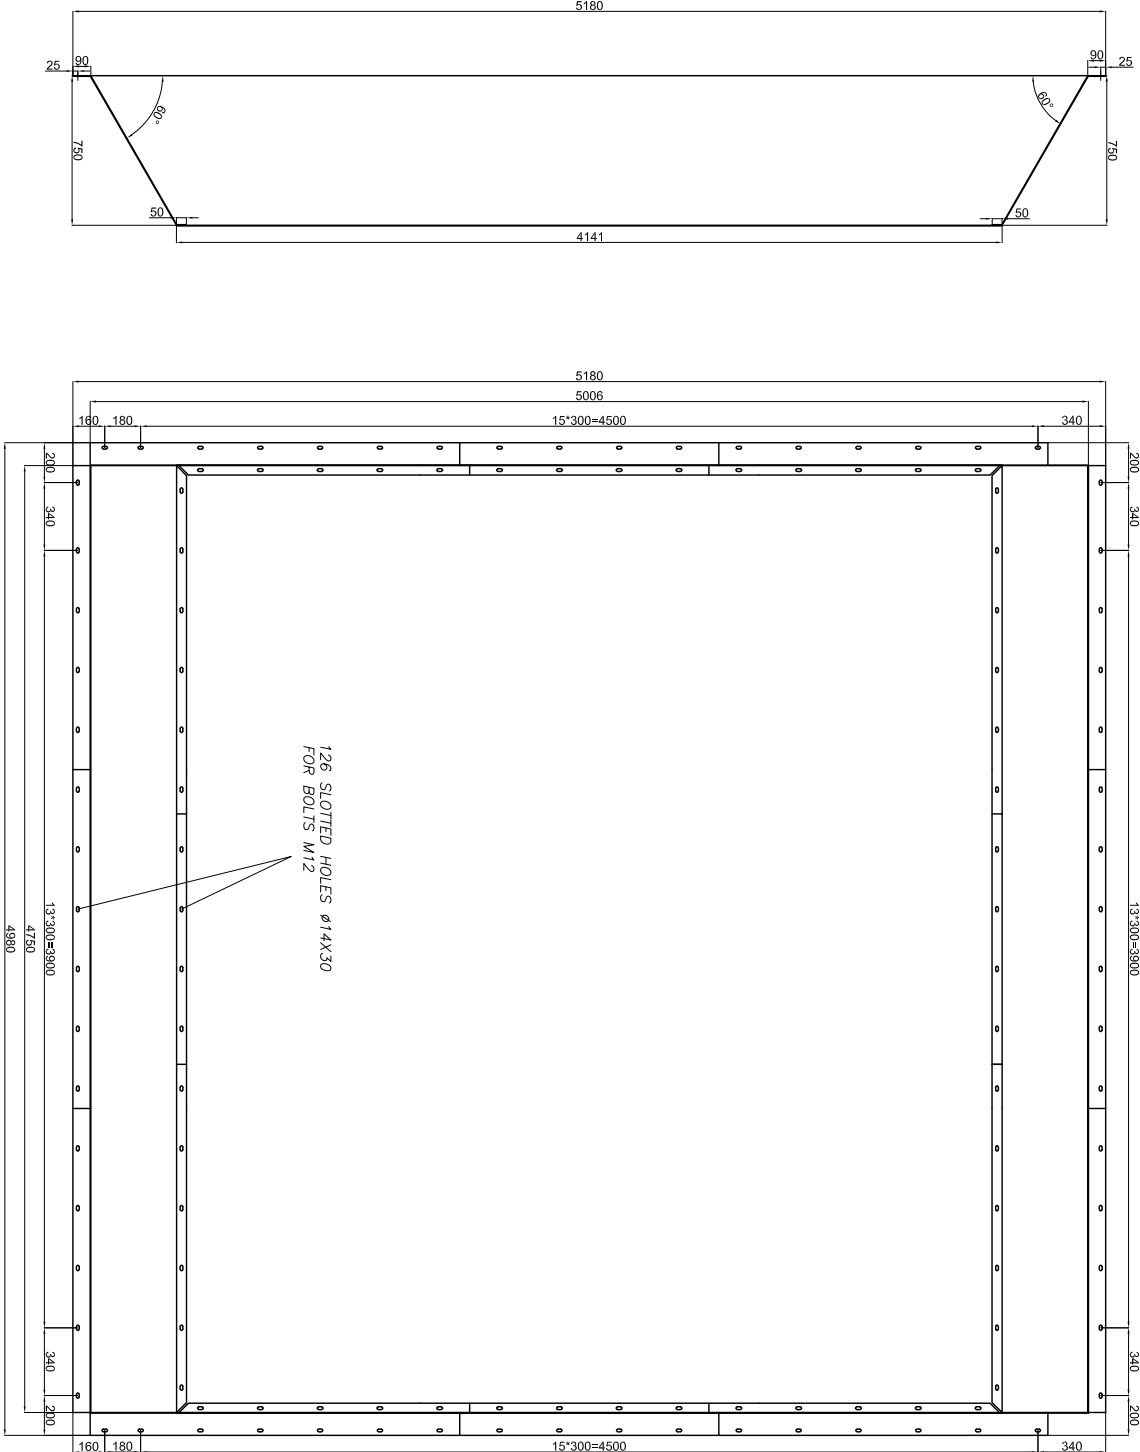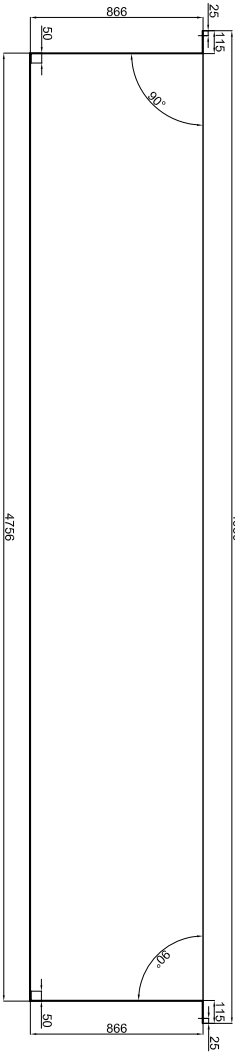

PROJ.	P.O NO.	DISC.	DOC TYPE	TAG NO.	SERIAL NO.	REV.	SHEET NO.:
SDHT	TG0004	ME	VDWG	AE1501	016	03	2 of 4

FILE REF. ADDRESS:	
P.O.I.: IFA	



PLENUM ASSEMBLY

DECK ASSEMBLY

<div> DISTILLATE HYDROREATING PROJECT SHIRAZ OIL REFINERY</div> <div></div>										<div> Oil Design & Construction Co.</div> <div></div>									
03	14-Mar-2021	AS BUILT NOT SEND	Z.Zare'i	M.Firoozi	P.Karimzadeh														
02	09-Mar-2021	AS BUILT NOT SEND	Z.Zare'i	M.Firoozi	P.Karimzadeh														
01	08-Mar-2021	ISSUED FOR APPROVAL	Z.Zare'i	M.Firoozi	P.Karimzadeh														
00	16-Feb-2021	ISSUED FOR APPROVAL	Z.Zare'i	M.Firoozi	P.Karimzadeh														
REV	DATE	DESCRIPTION	PREP.	CHK.	APP.														
DRAWING TITLE: Plenum & Fan Ring Drawing AE-1501																			
PREP.: Z.Zare'i			CHECK: M.Firoozi			APPR.: P.Karimzadeh													
CONT. JOB No.:						CONT. DWG. No.:			SC:None										
DOCUMENT No.:									SIZE: A3										
PROJ.	P.O NO.	DISC.	DOC TYPE	TAG NO.	SERIAL NO.	REV.	SHEET NO.:												
SDHT	TG0004	ME	VDWG	AE1501	016	03	4 of 4												
FILE REF. ADDRESS:																			