



REFERENCE DRAWINGS	
TITLE	DWG. No.
General Arrangement Drawing AE-1601 & AE-1602	SDHT-TG0035-ME-VDWG-AE1601,1602-041
Steel Structure Drawing AE-1601 & AE-1602	SDHT-TG0035-ME-VDWG-AE1601,1602-045
Fan Data Sheets AE-1601 / AE-1602	SDHT-TG0035-ME-VDS-AE1601,1602-005
Fan & Motor Support Drawing AE-1601/AE-1602	SDHT-TG0035-ME-VDWG-AE1601,1602-015

NOTE :


1. ALL DIMENSIONS ARE IN mm EXCEPT SPECIFIED .
2. MARKING : 17202-AE-1901-PL-PART NO.
3. SURFACE PROTECTION ACCORDING TO :  
SDHT-TG0035-ME-VP-RC-0405-011-00
4. BOLTS ARE M12x40  
BOLTING : ASTM A325/ A563  
TWO FLAT WASHER : DIN 125
5. TOTAL REQUIRED QUANTITY FOR M12\*40= 263 (SET / UNIT)  
M 12\*50= 80 (SET / UNIT)
6. TOTAL QUANTITY FOR AE-1601 & AE-1602 : 1 No.
7. PAY ATTENTION TO THE PLAN VIEW FOR INSTALL THE PLENUM
8. ALL BOLTS WHICH FASTEN PLENUM TO THE STRUCTURE  
SHALL BE M12x50

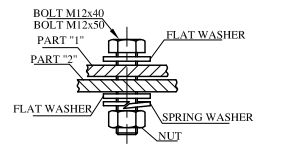

### JOINT DETAIL

Code1	<input type="checkbox"/> Approved (Vendor shall issue "AFC"/ "FIN" status)				
Code2	<input type="checkbox"/> Approved as noted (Vendor to amend and submit the 'Issued for Approval' status)				
Code3	<input type="checkbox"/> Commented (Vendor to amend and submit the 'Issued for Approval' status.)				
Code4	<input type="checkbox"/> Rejected (Vendor to resubmit with some revision)				
<p>The above checking result by Purchaser shall in no way relieve Vendor of any liability, obligation and responsibility out of the purchase order and the mutual agreement in writing</p>					
<div style="display: flex; justify-content: space-between; align-items: center;"><div style="text-align: center;"><p><b>Gill Design &amp; Construction Co.</b></p></div><div style="text-align: right;"><p>DATE : _____</p><p>DEPT: _____</p><p>Signature : _____</p></div></div>					
Only for internal review					
CV	PI	EL	IN	ME	MA
ST	MC	PR	SF	HV	TC

0A	19.Jun.2023	AS BUILT NOT SEND	A.Shaterpour	F.Mohammadi	P.Karimizadeh
00	23.May.2023	ISSUED FOR INFORMATION	A.Shaterpour	F.Mohammadi	P.Karimizadeh
REV.	DATE	DESCRIPTION	PREP.	CHK.	APP.

Distillate Hydrotreating Project Shiraz Oil Refinery 

## Oil Design Construction



17202

DRAWING TITLE:

Plenum & Fan Ring Drawing  
AE-1601/AE-1602





PREP.:		CHECK:			APPR.:	
CONT. JOB No.:				CONT. DWG. No.:		
DOCUMENT No.:						SC.: --
SDHT-TG-0035ME-VDWG-AE1601,1602-011						SIZE: <b>A3</b>
PROJ.	P.O NO.	DISC.	DOC TYPE	TAG NO.	SERIAL NO.	REV.: SHEET NO.:
SDHT	TG0035	ME	VDWG	AE1601,1602	011	OA 1 OF 4

FILE REF. ADDRESS:	P.O.I.: IFI
--------------------	-------------









PART LIST FAN RING 17202-AE 1601&1602 (FOR ONE UNIT)						
NO	MATERIAL	DIM	QTY	U.WEIGHT	T.WEIGHT	MARKING
1	A36	1680*700*3	2	28	56	17202-AE 1601&1602-FR-1
2	A36	1680*700*3	2	28	56	17202-AE 1601&1602-FR-2
3	A36	900*207*15	4	22	88	
4	A36	600*55*8	8	2	16	
5	A325	M 12*40	16			
				TOTAL	216	

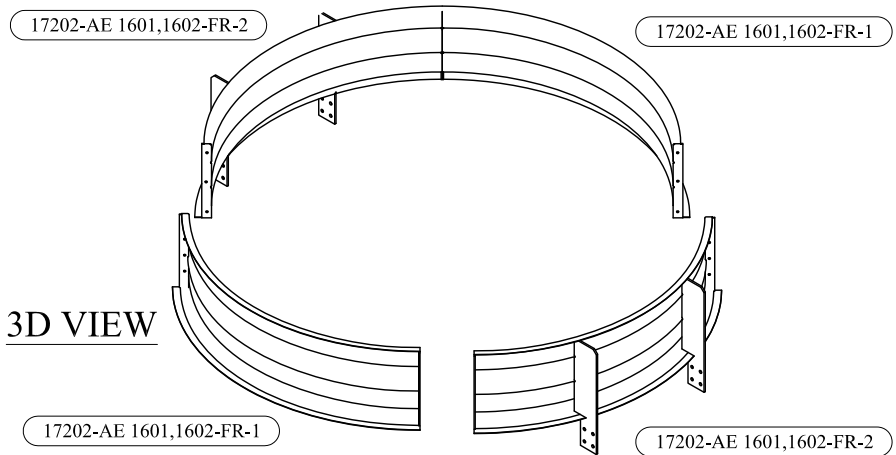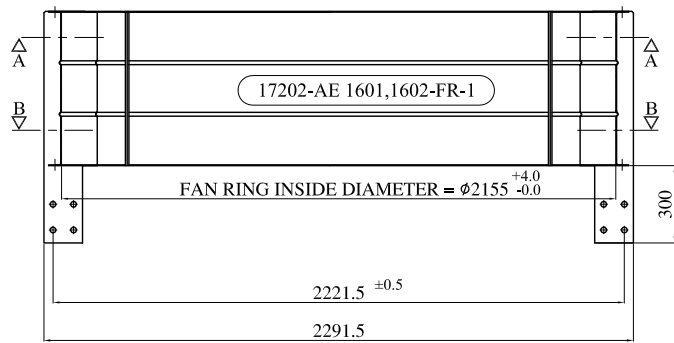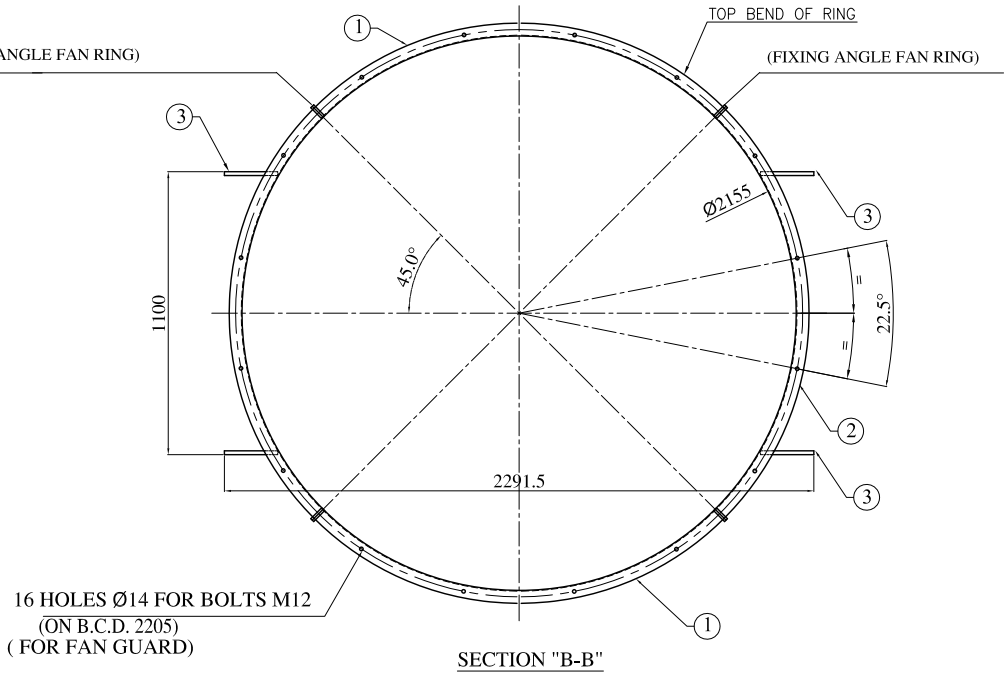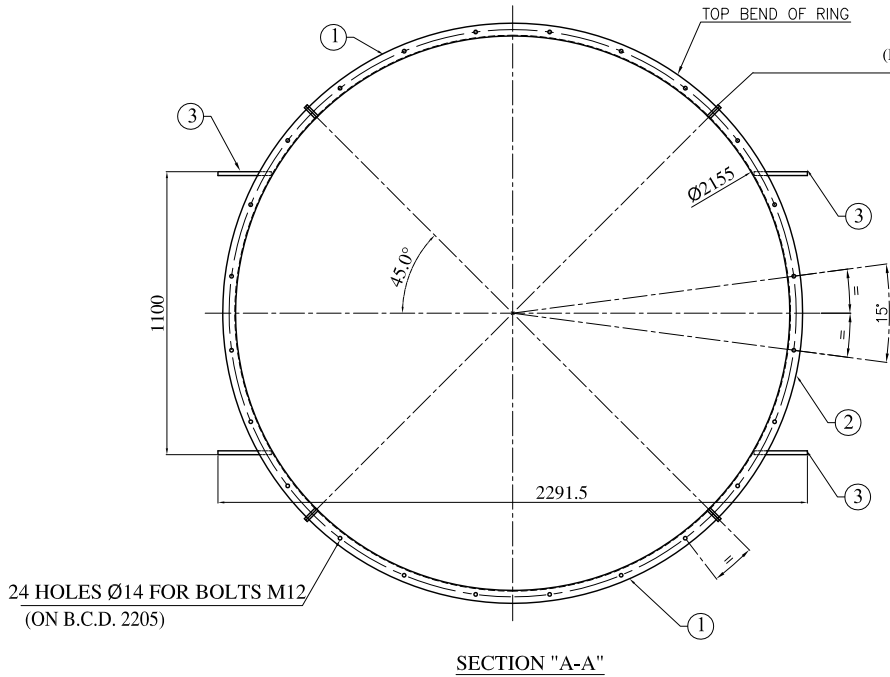
TOTAL QUANTITY FOR AE-1601 & AE-1602 : 2 No.

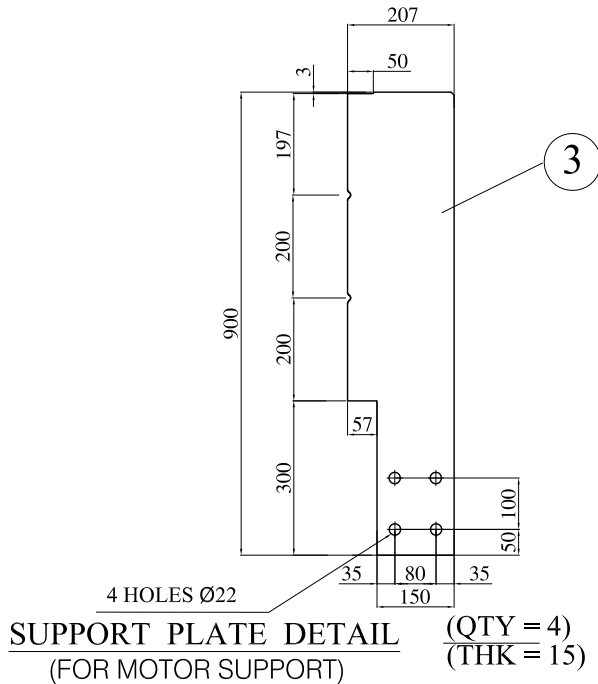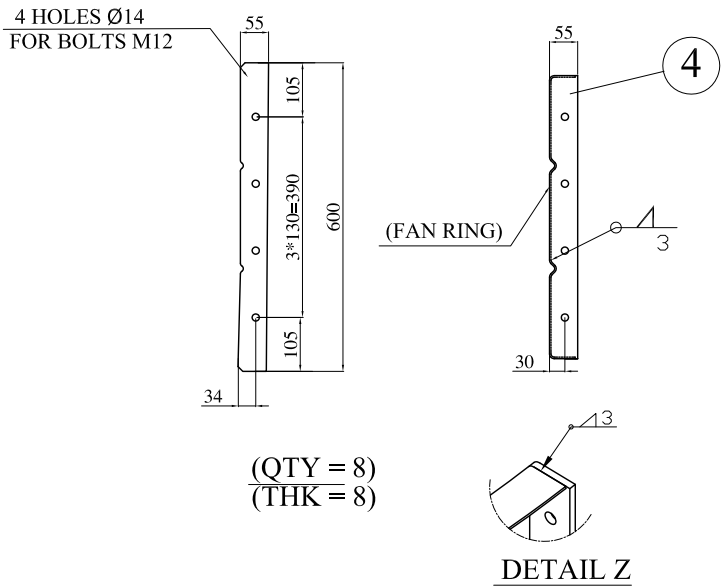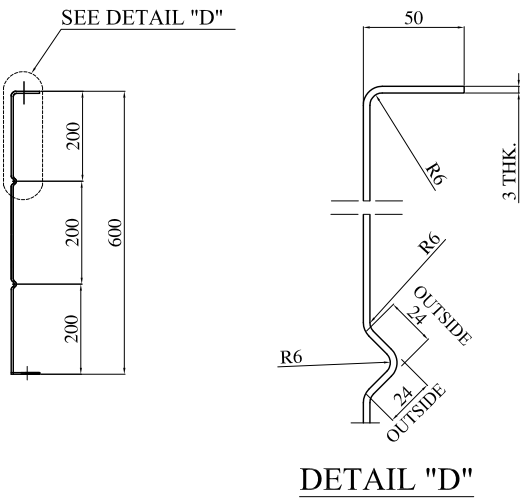

Code1	<input type="checkbox"/>	Approved (Vendor shall issue "AFC"/ "FIN" status)
Code2	<input type="checkbox"/>	Approved as noted (Vendor to amend and submit the 'Issued for Approval' status)
Code3	<input type="checkbox"/>	Commented (Vendor to amend and submit the 'Issued for Approval' status.)
Code4	<input type="checkbox"/>	Rejected (Vendor to resubmit with some revision)
The above checking result by Purchaser shall in no way relieve Vendor of any liability, obligation and responsibility out of the purchase order and the mutual agreement in writing		
		DATE : DEPT : Signature :
Only for internal review		
CV	PI	EL
ST	MC	PR
IN	SF	ME
MA	HV	TC



0A	19.Jun.2023	AS BUILT NOT SEND	A.Shaterpour	F.Mohammadi	P.Karimizadeh
00	23.May.2023	ISSUED FOR INFORMATION	A.Shaterpour	F.Mohammadi	P.Karimizadeh
REV.	DATE	DESCRIPTION	PREP.	CHK.	APP.
<div>Distillate Hydrotreating Project Shiraz Oil Refinery<div>شیراز پالایشگاه SHIRAZ</div></div>					
<div><div>Oil Design &amp; Construction Co.</div></div>				<div><div>AAC 17202</div></div>	
DRAWING TITLE:					
Plenum & Fan Ring Drawing AE-1601/AE-1602					
PREP.:		CHECK:		APPR.:	
CONT. JOB No.:			CONT. DWG. No.:		
DOCUMENT No.:					SC.: --
SDHT-TG-0035ME-VDWG-AE1601,1602-011					SIZE: A3
PROJ.	P.O NO.	DISC.	DOC TYPE	TAG NO.	SERIAL NO.
SDHT	TG0035	ME	VDWG	AE1601,1602	011
REV.:					SHEET NO.:
OA					3 OF 4

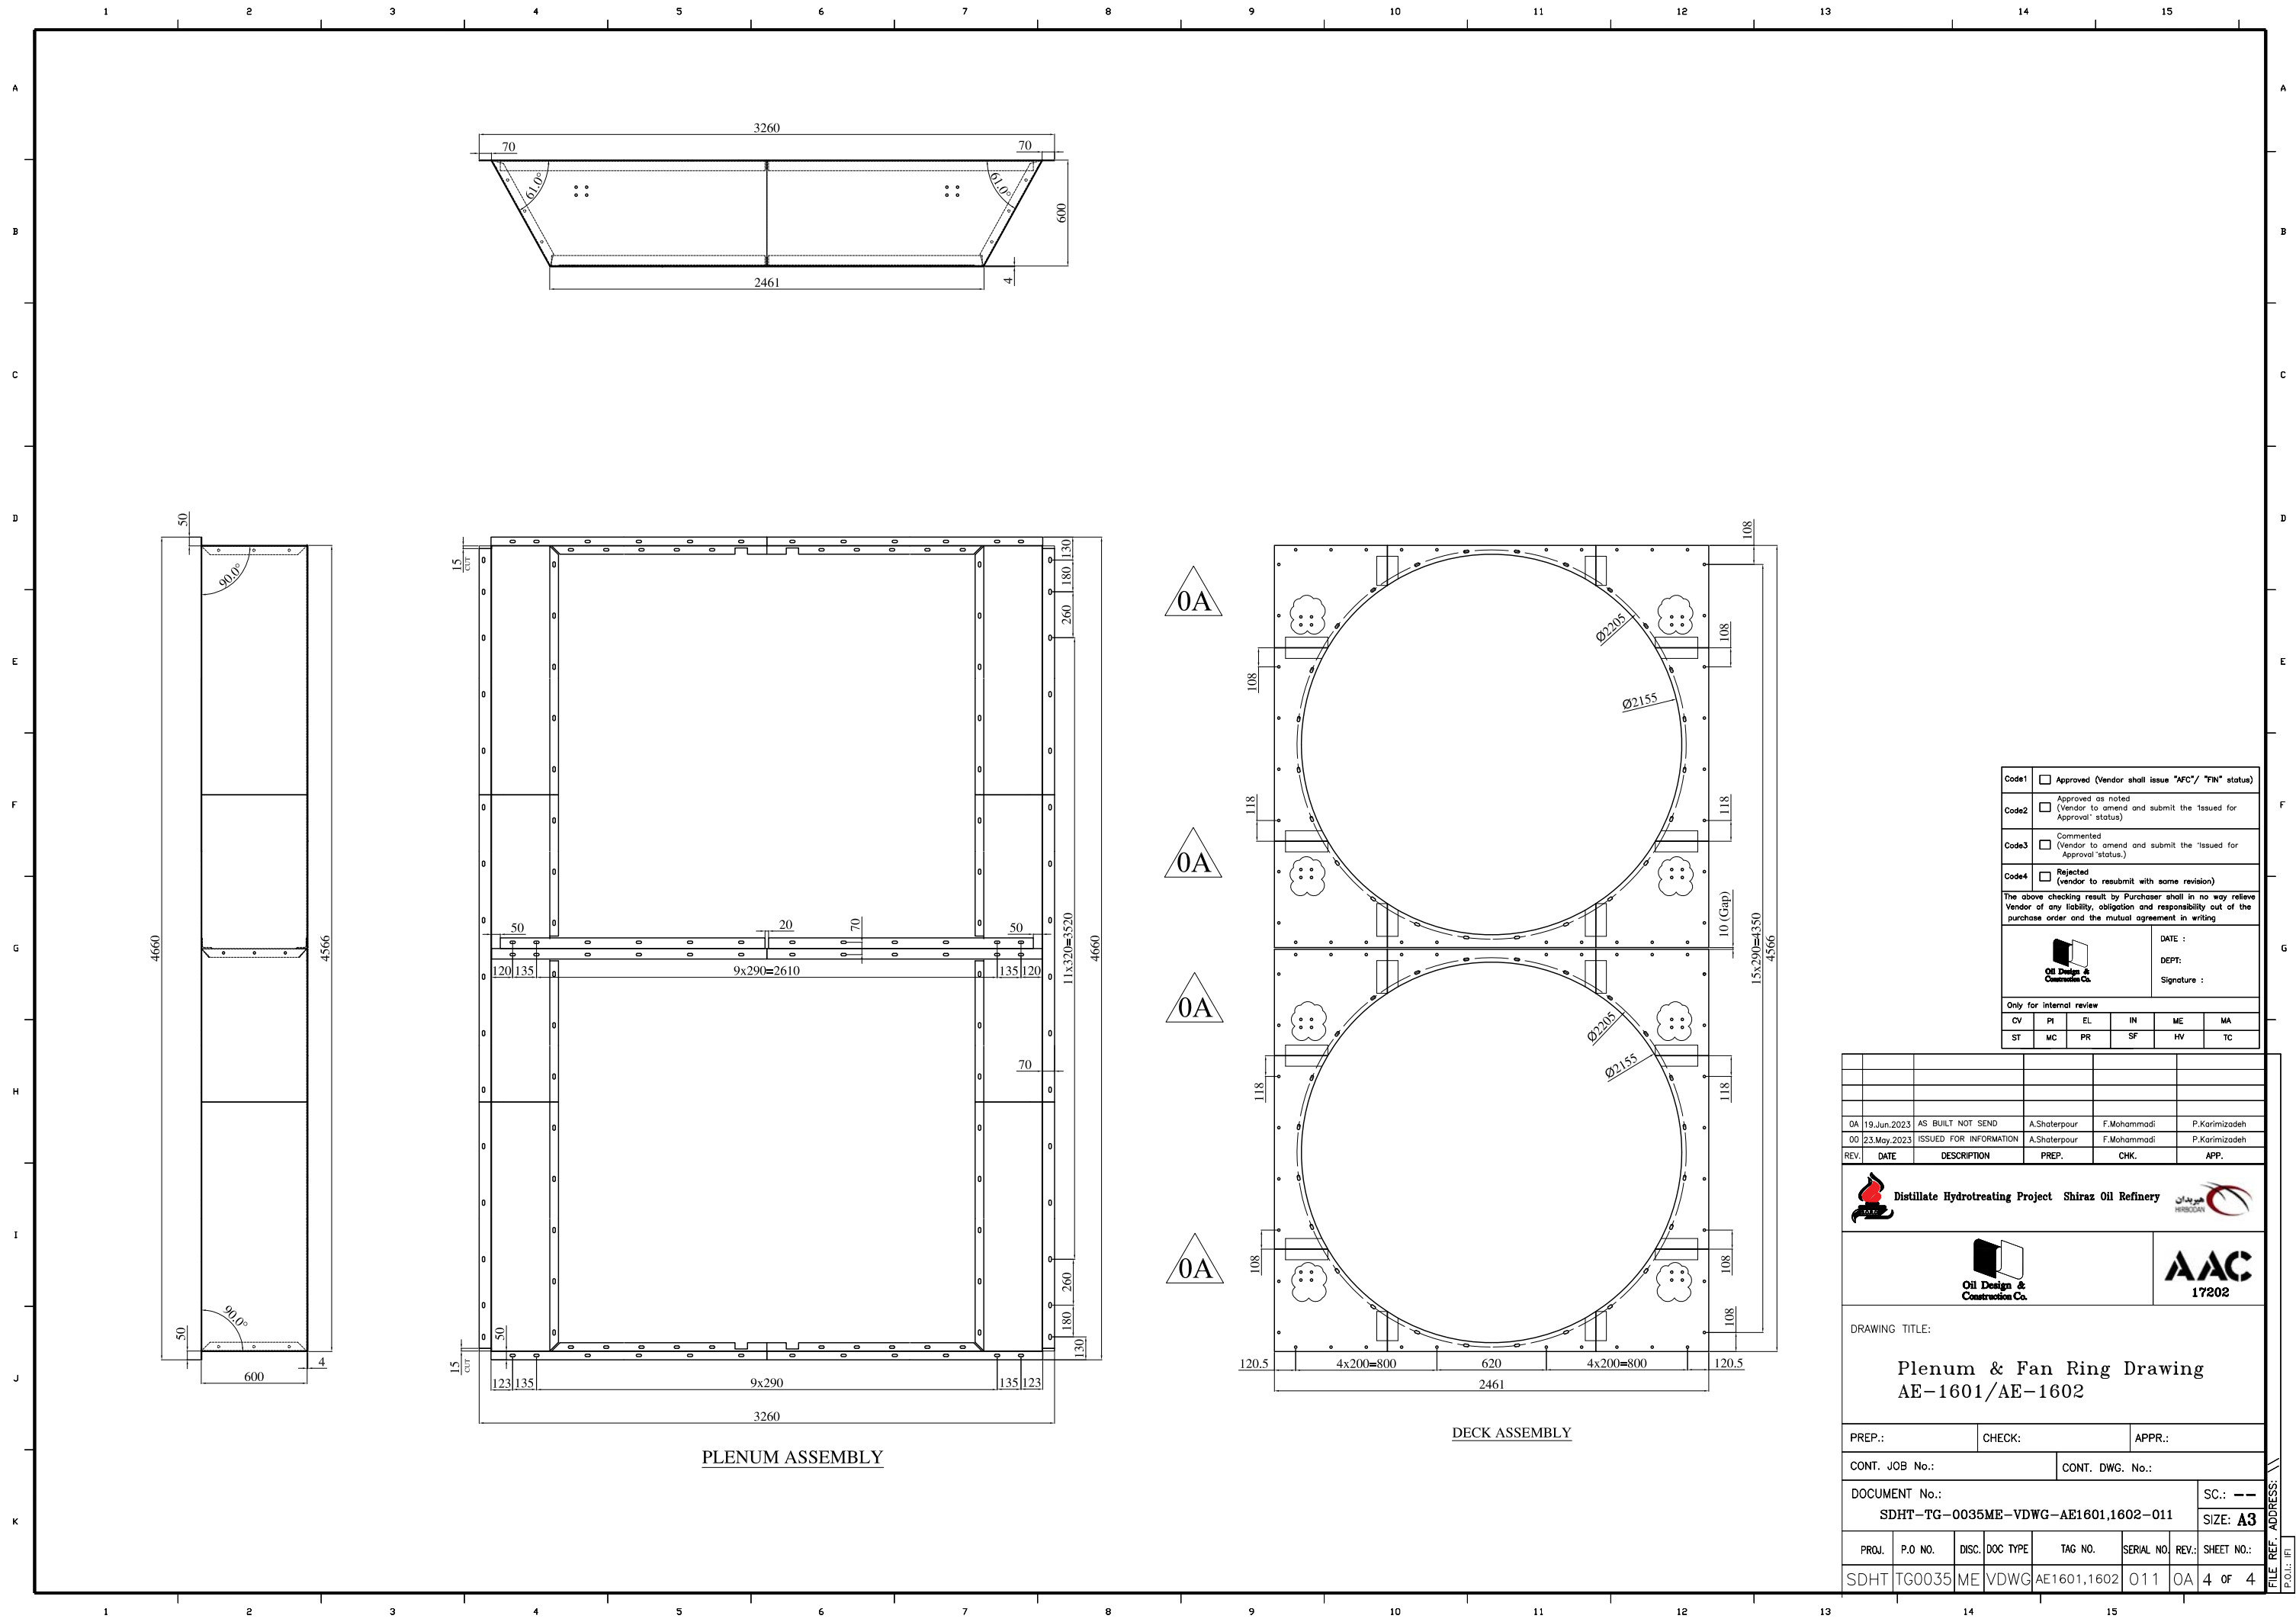

Code1	<input type="checkbox"/>	Approved (Vendor shall issue "AFC"/ "FIN" status)
Code2	<input type="checkbox"/>	Approved as noted (Vendor to amend and submit the 'Issued for Approval' status)
Code3	<input type="checkbox"/>	Commented (Vendor to amend and submit the 'Issued for Approval' status.)
Code4	<input type="checkbox"/>	Rejected (Vendor to resubmit with some revision)
The above checking result by Purchaser shall in no way relieve Vendor of any liability, obligation and responsibility out of the purchase order and the mutual agreement in writing		
		DATE : DEPT : Signature :
Only for internal review		
CV	PI	EL
ST	MC	PR
		IN
		SF
		ME
		HV
		MA
		TC

Distillate Hydrotreating Project Shiraz Oil Refinery



AAC  
17202

DRAWING TITLE:  
**Plenum & Fan Ring Drawing**  
**AE-1601/AE-1602**

PREP.:		CHECK:		APPR.:	
CONT. JOB No.:				CONT. DWG. No.:	
DOCUMENT No.:					
SDHT-TG-0035ME-VDWG-AE1601,1602-011					
SC.: --					
SIZE: A3					
PROJ.	P.O NO.	DISC.	DOC TYPE	TAG NO.	SERIAL NO.
SDHT	TG0035	ME	VDWG	AE1601,1602	011
REV.:					SHEET NO.:
4 OF 4					0A

FILE REF. ADDRESS:  
P.O.L: IFT