


PART LIST FOR ONE UNIT						
NO.	DIMENSION (mm)	MATERIAL	QTY.	WEIGHT (Kg)	TOTAL WEIGHT (Kg)	MARKING
1	3120x550x3	A36	2	40.5	81	17199-32-HX-01-FR-1
2	3120x550x3	A36	2	40.5	81	17199-32-HX-01-FR-2
3	3182x115x3	A36	4	8.5	34	--
4	3269x50x4	A36	4	5	20	--
5	600x55x8	A36	8	2	16	--
6	900x208x15	A36	4	22	88	--
7	900x208x15	A36	2	22	44	--
8	M12x40	A325	24(Sets)	BOLT /NUT /2 F.WASHER /S.WASHER		
TOTAL WEIGHT FOR ONE UNIT (Kg) :					364	

23.Jan.2023	AS BUILT NOT SEND	A.Shaterpour	F.Mohamadi	P.Karimzadeh	
11.Dec.2022	FI	A.Shaterpour	F.Mohamadi	P.Karimzadeh	
10.Aug.2022	FI	A.Shaterpour	M.R.Shahparasi	P.Karimzadeh	
REV.	DATE	DESCRIPTION	PREP'D	CHK'D	APP'D
<div><div><div><div></div><div>P</div><div>Part Faravon</div></div><div><div><div></div><div>H</div><div>HALYCO</div></div><div>شاهروز توسعه صنعتی Shahrooz Industrial Development Co.</div></div></div></div>					
CONTRACTOR(S):					
<div><div><div></div><div>AAC</div><div>ABAN AIR COOLER</div></div></div>					
PROJECT TITLE: 12,000 tpy FeSi Expansion Plant (32-HX-01)					
DRAWING TITLE: Plenum & Fan Ring Drawing					
PREP.:		CHECK:		APPR.:	
CONT. JOB No.:			CONT. DWG. No.:		
DOCUMENT No.:				SCALE: NONE	
AGH2-ME-30-AFD-HX-016				SIZE: A3	
PLAN/PRJ/SUB:	UNIT CODE:	DOC TYPE:	SERIAL NO.:	REV.:	SHEET NO.:
AGH2	ME	30-AFD-HX	016	1A	3 OF 4

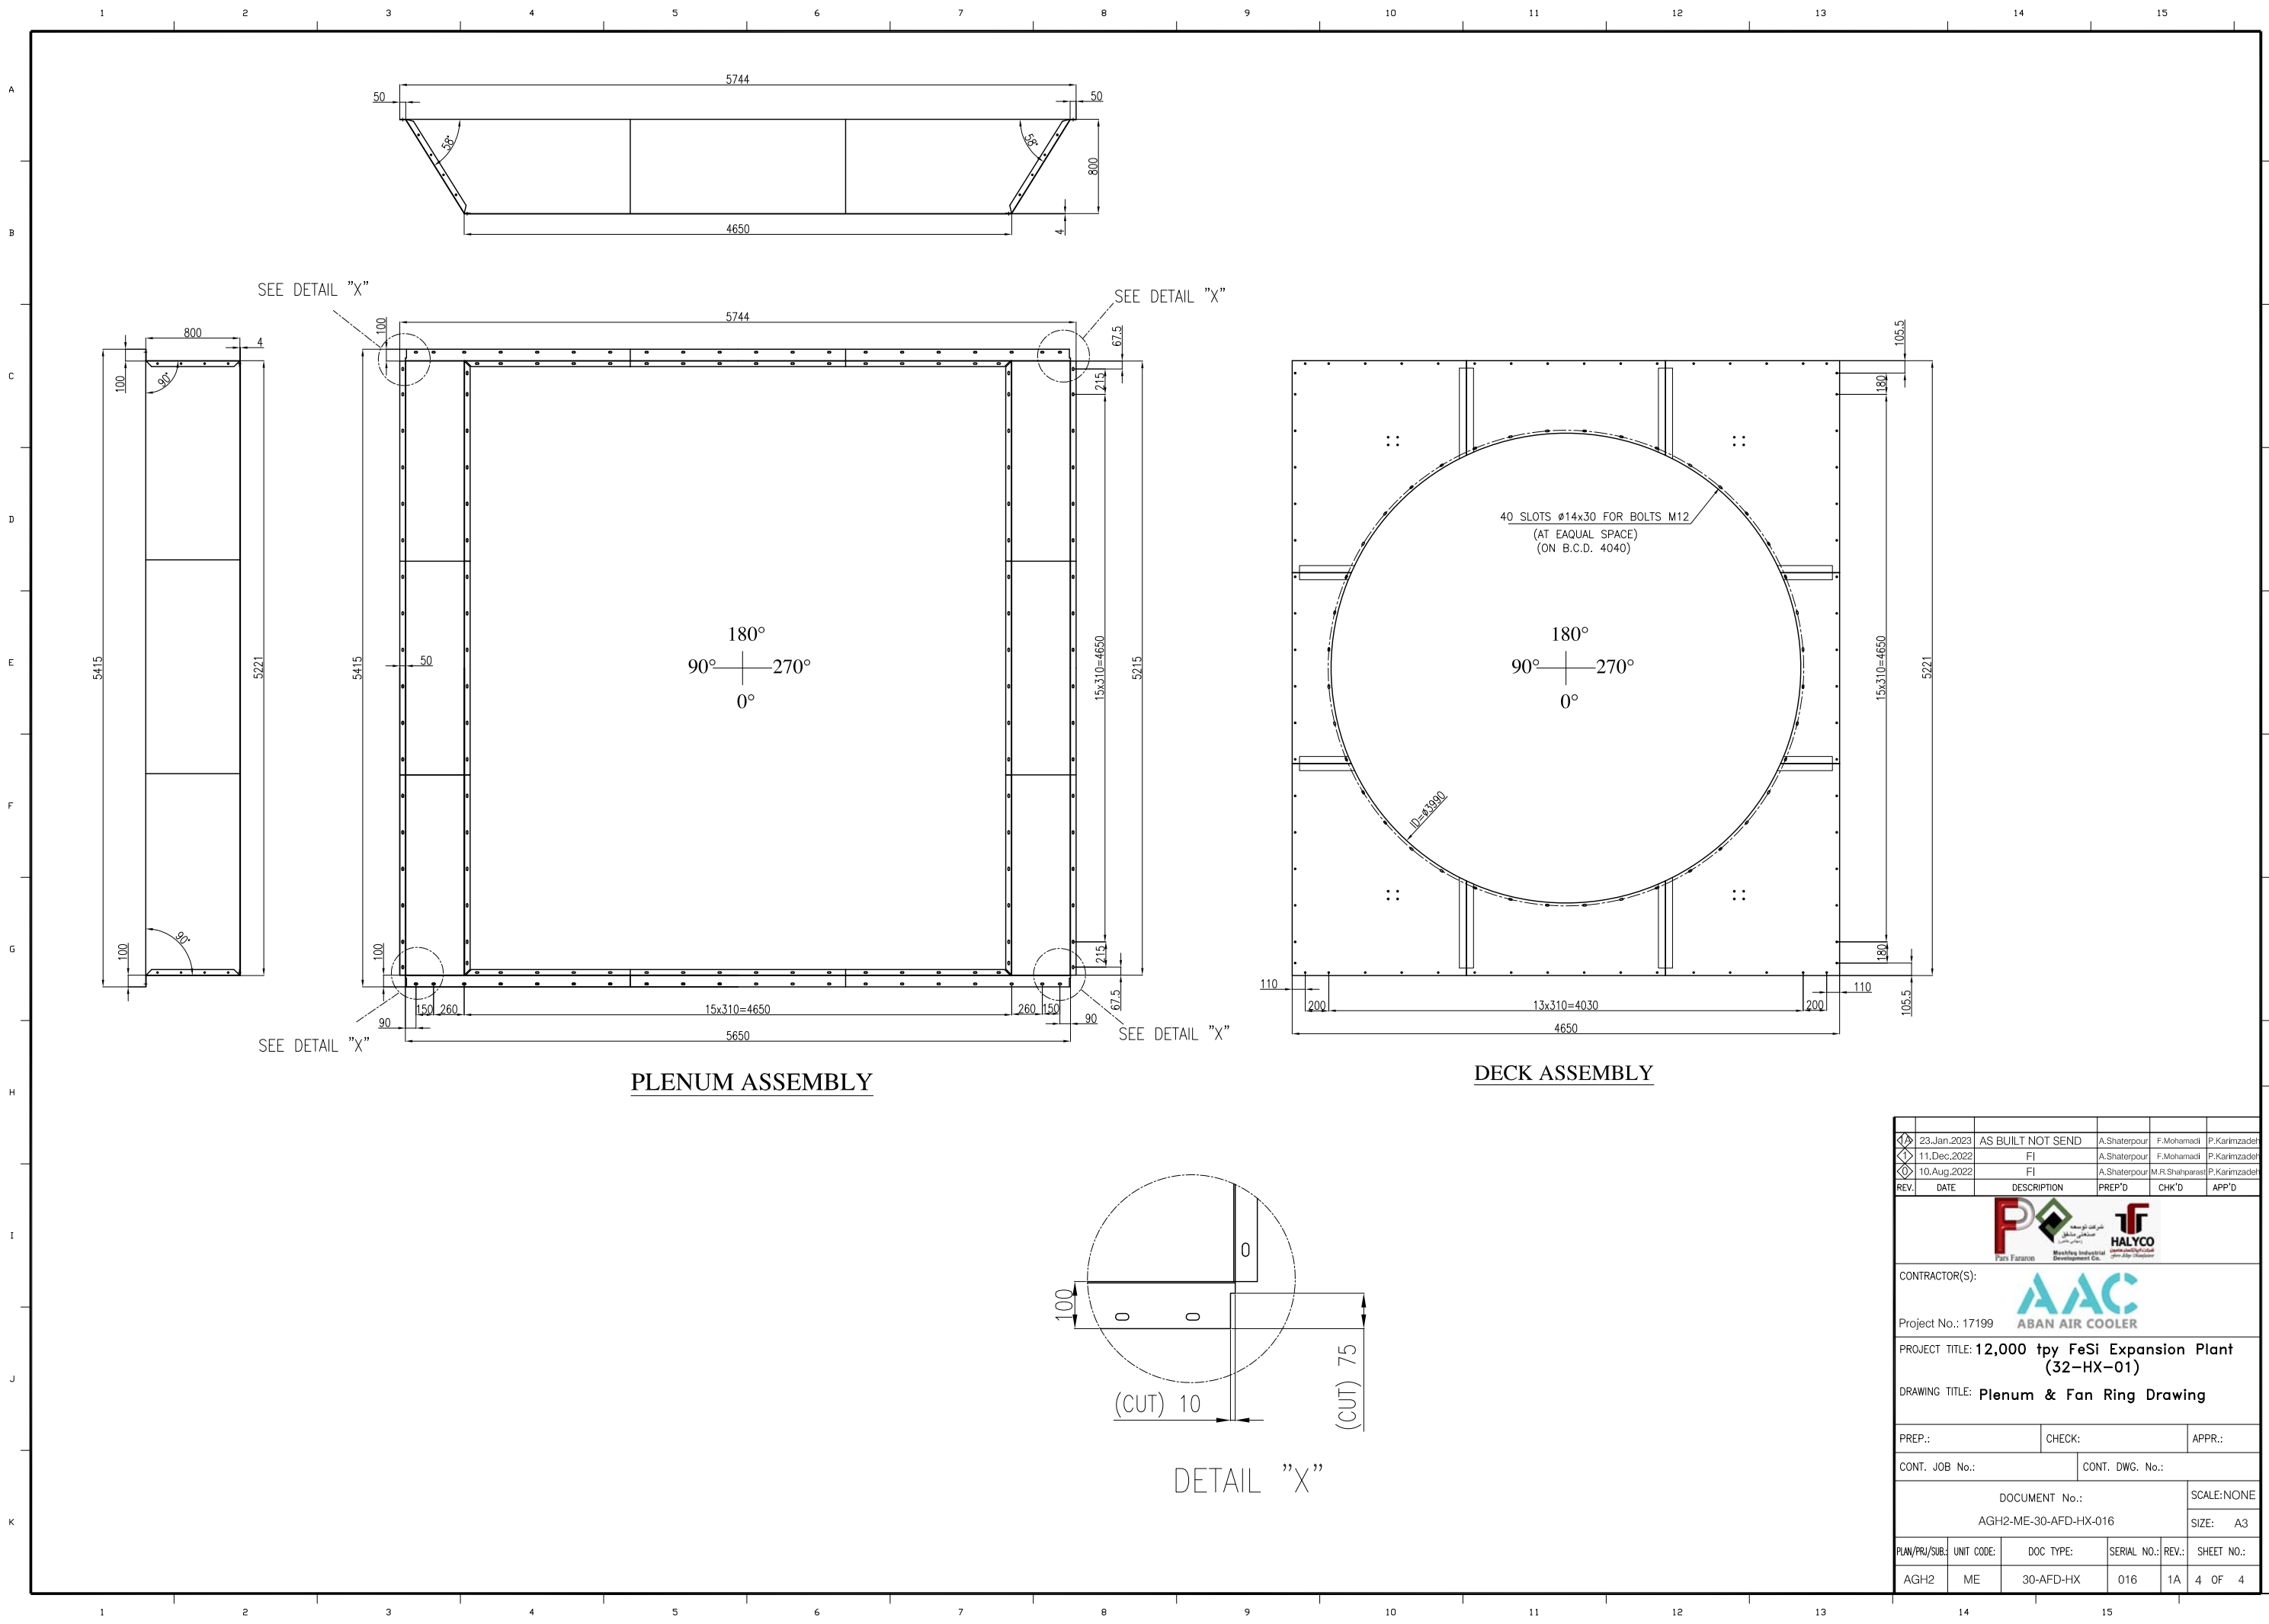

PLENUM ASSEMBLY

DECK ASSEMBLY

DETAIL "X"

23.Jan.2023	AS BUILT NOT SEND	A.Shaterpour	F.Mohamadi	P.Karimzadeh	
11.Dec.2022	FI	A.Shaterpour	F.Mohamadi	P.Karimzadeh	
10.Aug.2022	FI	A.Shaterpour	M.R.Shahpoori	P.Karimzadeh	
REV.	DATE	DESCRIPTION	PREP'D	CHK'D	APP'D
<div><div><div><div><div></div><div>Far's Fararon</div></div><div><div>مهندسی نوین</div><div>مهندسی مشاور</div><div>مهندسین مشاور</div></div></div><div><div><div></div><div>HALYCO</div><div>مهندسی نوین</div><div>مهندسی مشاور</div><div>مهندسین مشاور</div></div><div><div>Shahrooz Industrial Development Co.</div><div>مهندسی نوین</div><div>مهندسی مشاور</div><div>مهندسین مشاور</div></div></div></div><div>CONTRACTOR(S):</div><div>Project No.: 17199</div><div>PROJECT TITLE: 12,000 tpy FeSi Expansion Plant (32-HX-01)</div><div>DRAWING TITLE: Plenum & Fan Ring Drawing</div><div>PREP.:<div>CONT. JOB No.:</div></div><div>CHECK:<div>CONT. DWG. No.:</div></div><div>APPR.:<div>DOCUMENT No.:</div></div><div>AGH2-ME-30-AFD-HX-016</div><div>SCALE: NONE</div><div>SIZE: A3</div><div>PLAN/PRI/SUB.: UNIT CODE: DOC TYPE: SERIAL NO.: REV.: SHEET NO.:</div><div>AGH2 ME 30-AFD-HX 016 1A 4 OF 4</div></div>					