




PLENUM & DECK PLATE - DEVELOPMENT VIEW

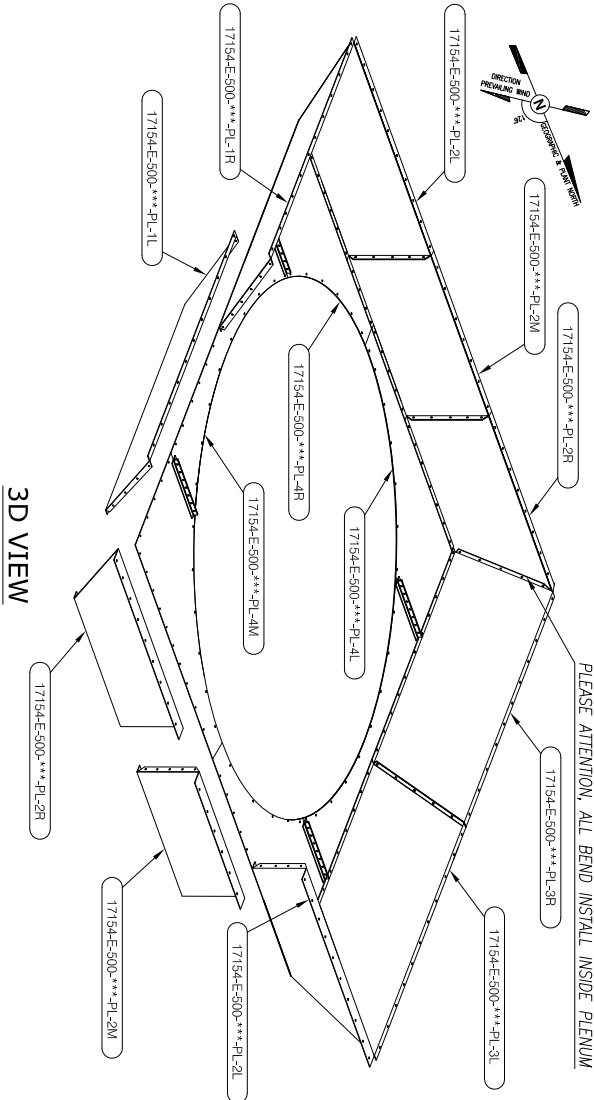


3D VIEW

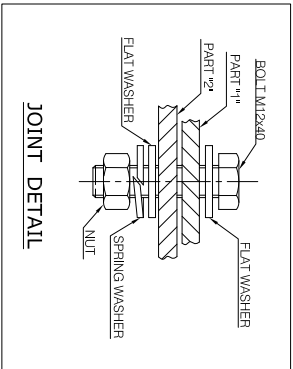


JOINT DETAIL

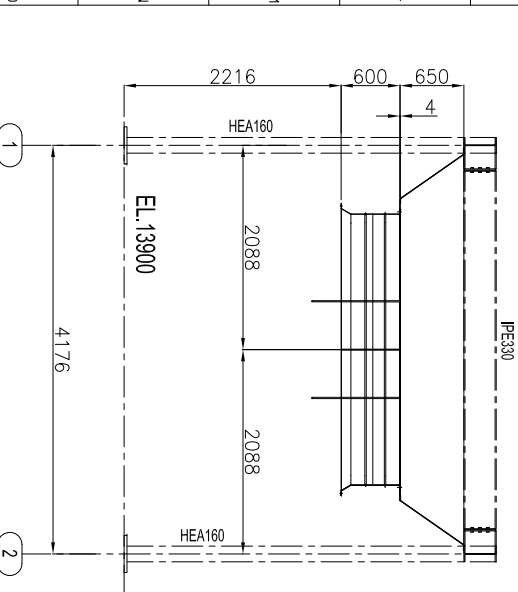

ELEVATIO VIEW

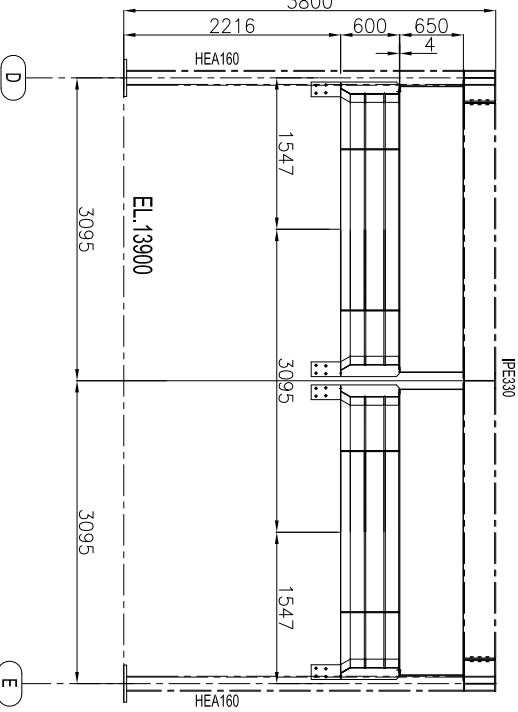

SIDE VIEW

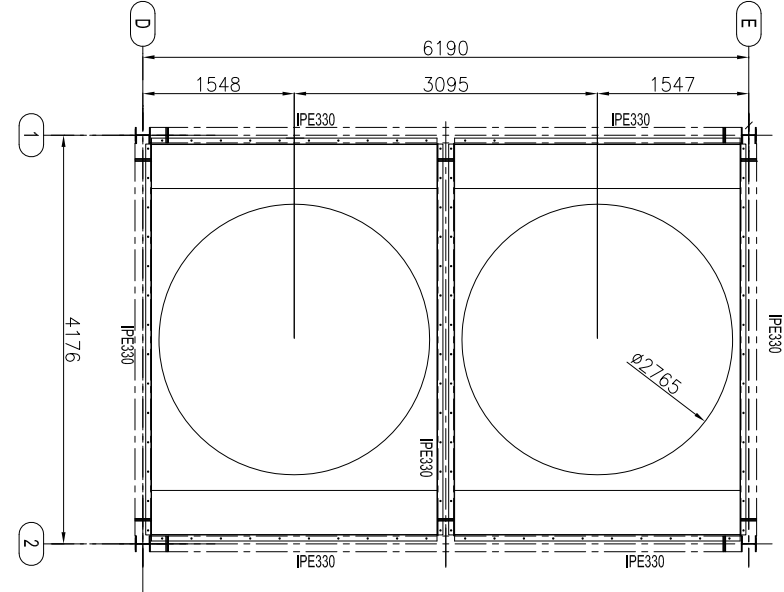

PLAN VIEW

GENERAL NOTES

- ALL DIMENTIONS ARE IN mm EXCEPT SPECIFIED .
- MARKING : 17153-E-500-*** (SEE TABLE MARKING)-PL-PART NO. .
- SURFACE FINISHING :
HOT DIP GALVANIZED ACCORDING TO ASTM A123 & A153 OR PAINTING ACCORDING DOCUMENT NO. : NGWK-AB-0500-VDME-PRDS-0032
- ALL BOLT ARE M12x40
BOLTING : DIN 933/ DIN 934 (HOT DIP GALVANIZED)
TWO FLAT WASHER / SPRING WASHER : DIN 121/ DIN 127
TOTAL REQUIRED QUANTITY : 175 SETS / UNIT
5- QUANTITY : 2 UNITS PER BAY (2 UNITS FOR EACH ITEM)
TOTAL FOR 2 ITEMS : 4 UNITS

SPECIFIC NOTES

- ALL HOLES ARE $\phi 14$ FOR BOLT M12 .
- ALL SLOTTED HOLES ARE $\phi 14 \times 20$ FOR BOLTS M12 .

ABBREVIATIONS & LEGEND

PL. = PLENUM
FR. = FAN RING

REFERENCE DRAWINGS

DESCRIPTION	DWG. No.
FAN DATA SHEET	NGWK-AB-0500-VDME-SDS-0002
GENERAL ARRANGEMENT	NGWK-AB-0500-VDME-DWGA-0009
STEEL STRUCTURE	NGWK-AB-0500-VDME-DWEC-0012
FAN GUARD	NGWK-AB-0500-VDME-DWEC-0015

KEY PLAN

Code1	<input type="checkbox"/> (Approved) Vendor to submit * For Final (No comment & release for manufacturing)
Code2	<input type="checkbox"/> (Approved with comments) : Vendor shall correct / revise & resubmit it as * For Final (Released for manufacturing if change incorporated as indicated)
Code3	<input type="checkbox"/> (Commented) : Vendor shall correct / revise & resubmit it as *For Approval of the date specified ; (Corrected documents to be resubmitted before starting manufacturing)
Code4	<input type="checkbox"/> Not Acceptable quality (Reject)
Above checking results by SADAF shall in no way relieve Vendor of any liability, obligation and responsibility out of the purchase order and the mutual agreement in writing.	
Date:	
Dept:	
Signature:	

02	08.APR.2018	IFA	18mmx40	F.KOCHAMACHI	ESMEMBER	MA.
01	28.SEP.2016	IFA	MKEZAD	F.KOCHAMACHI	ESMEMBER	MA.
00	23.JUL.2016	IFA	MKEZAD	F.KOCHAMACHI	ESMEMBER	MA.
REV.	DATE	PURPOSE OF ISSUE	PREPARED	CHECKED	APPROVED	PURCHASER'S APPROVAL
CONTRACTOR:			VENDOR			
PETROLEUM ENGINEERING & DEVELOPMENT COMPANY (PEDEC)			CLIENT:			
West Karoun Area NGL 3200 Project			PETROLEUM ENGINEERING & DEVELOPMENT COMPANY			
Contract No.: 0500-VDME-91 - 754			EIED			







TITLE:

PLENUM & FAN RING DRAWING
E-500-101/201

STATUS : IFA	CLASS : 2	SCALE : NTS	SIZE : A3
DRAWING NUMBER	REV.	SHEET	
NGWK-AB-0500-VDME-DWEC-0014	02	1 OF 3	

AAC

Project No.: 17154

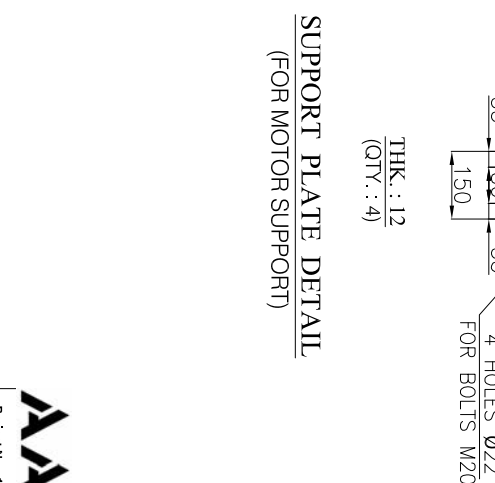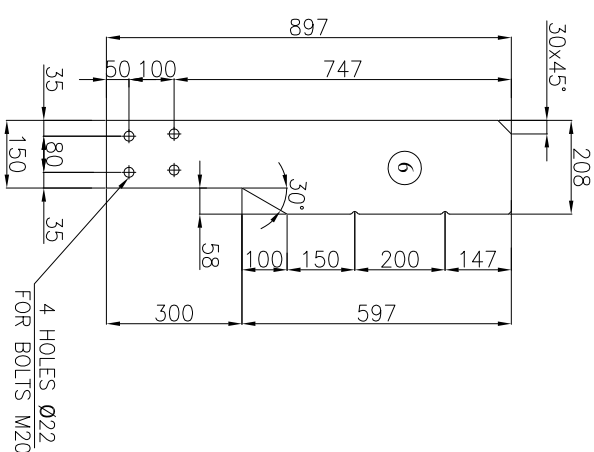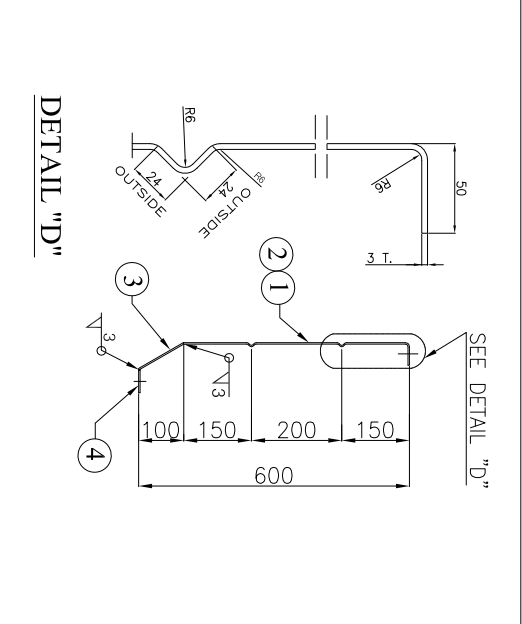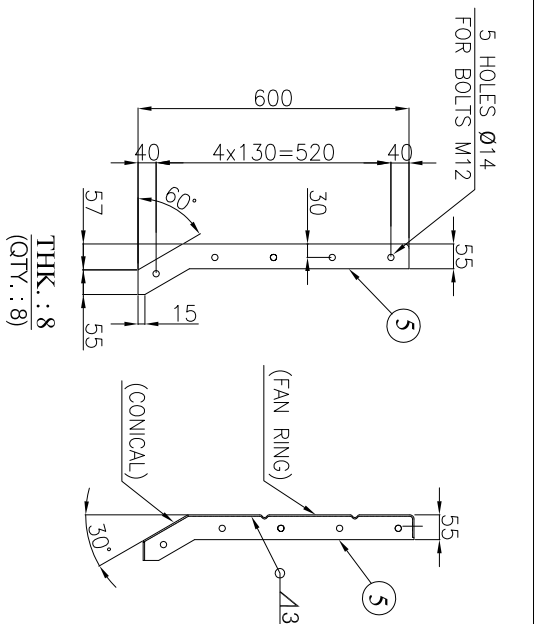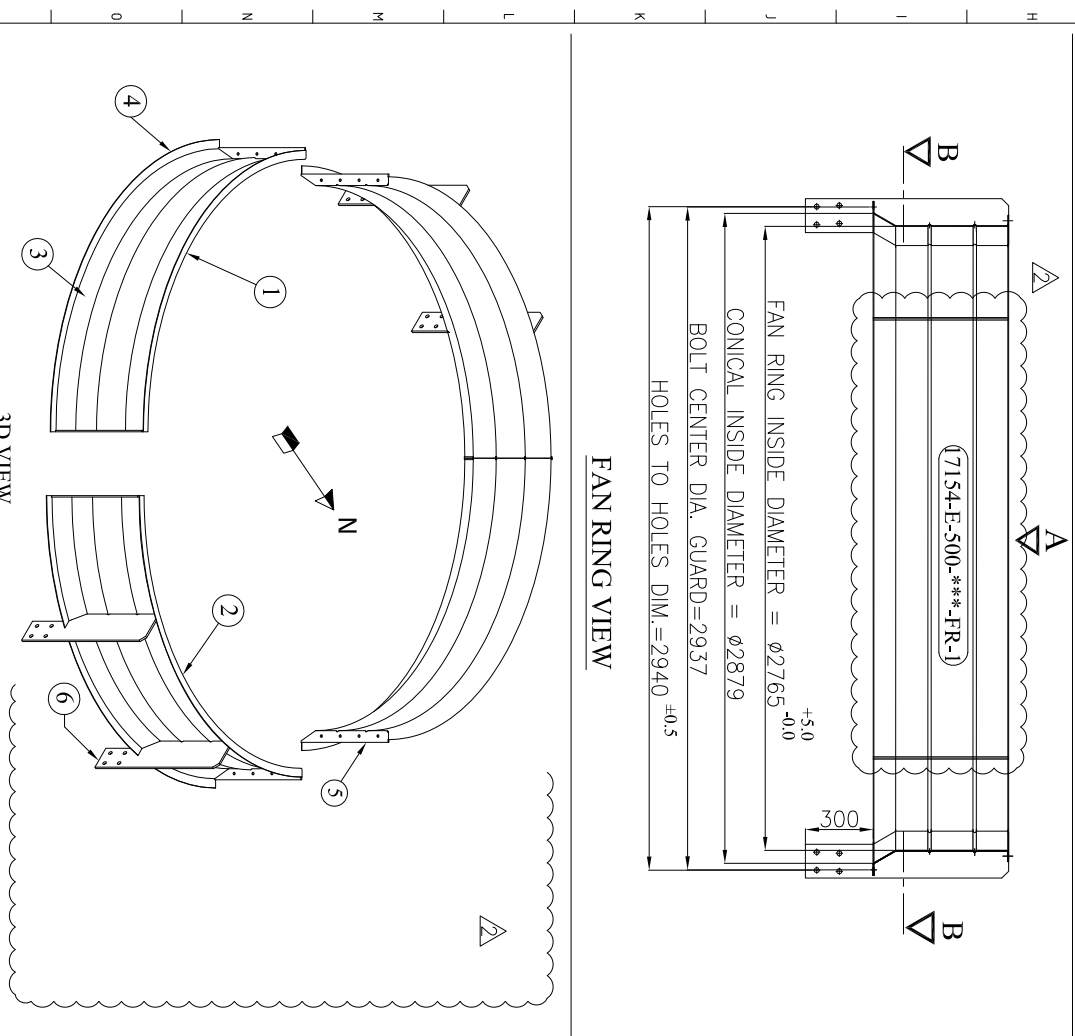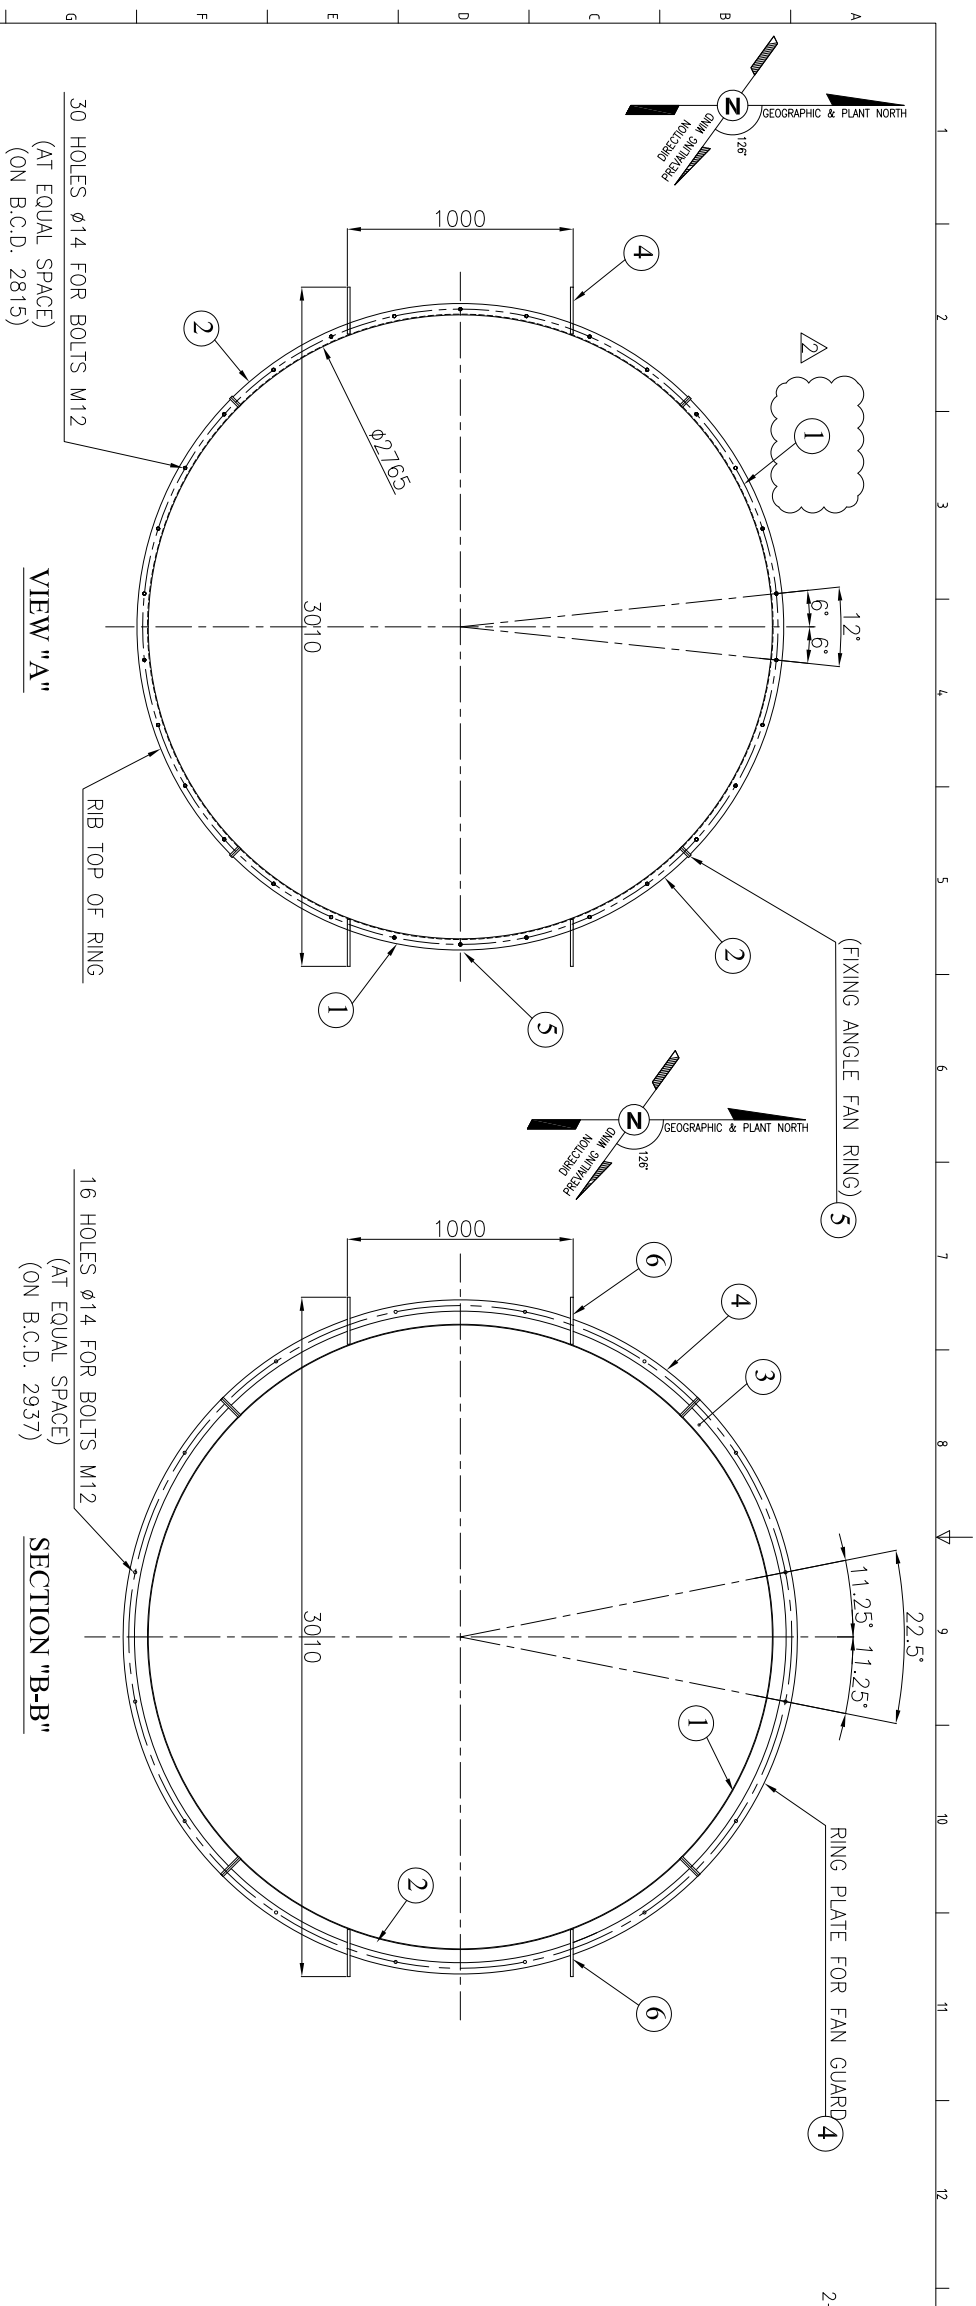

GENERAL NOTES												
1- ALL DIMENTIONS ARE IN mm EXCEPT SPECIFIED .												
MARKING : 17154-E-500-****(SEE TABLE MARKING)--FR-PART NO. .												
3- SURFACE FINISHING : HOT DIP GALVANIZED ACCORDING TO ASTM A123 & A153 OR PAINTING ACCORDING DOCUMENT NO. : NGWK-AB-0500-VDME-PRDS-0032												
4- ALL BOLT ARE M12x40												
BOLTING : DIN 933/ DIN 934 (HOT DIP GALVANIZED)												
TWO FLAT WASHER / SPRING WASHER : DIN 121/DIN 127												
TOTAL REQUIRED QUANTITY : 20 SETS / UNIT												
5- QUANTITY : 2 UNITS PER BAY (2 UNITS FOR EACH ITEM)												
TOTAL FOR 2 ITEMS : 4 UNITS												
PART LIST FOR ONE UNIT												

TABLE MARKING	
Item No. – ***	Qty. (Unit)
E-500 – 101	2
E-500 – 201	2

REV.	DATE	PURPOSE OF ISSUE	VENDOR			PURCHASER'S APPROVAL
			PREPARED	CHECKED	APPROVED	
02	08.APR.2018	IFA	U.HAMZANI	F.MOHAMMADI	B.SHEHREID	M.A.
01	28.SEP.2016	IFA	M.BEZJ	F.MOHAMMADI	B.SHEHREID	M.A.
00	23.JUL.2016	IFA	M.BEZJ	F.MOHAMMADI	B.SHEHREID	M.A.

 <p>PETROLEUM ENGINEERING & DEVELOPMENT COMPANY</p> <p>(PEDEC)</p> <p>West Karoun Area NGL 3200 Project</p>	 <p>SAZEH ENGINEERING & CONSTRUCTION CO.</p> <p>Contract No.: ٥٤ ط - 91 - 754</p>
 <p>سازش</p> <p>PETROLEUM ENGINEERING & DEVELOPMENT COMPANY</p>	 <p>EIED</p>

PLENUM & FAN RING DRAWING
E-500-101/201

STATUS:	IFA	CLASS:	2	SCALE:	NTS	SIZE:	A3
DRAWING NUMBER							
NGWK-AB-0500-VDME-DWEQ-0014						REV.	02
						SHEET	3 OF 3